



**NORTHWEST
DESIGN
GROUP**

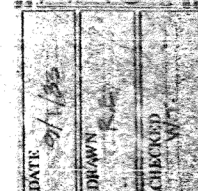


NERCO MINERAL BUILDING
1ST & HALL FAIRBANKS, ALASKA
BASEMENT & 2ND FLOOR PLANS

PROJECT
B301D

SHEET
A2
OF

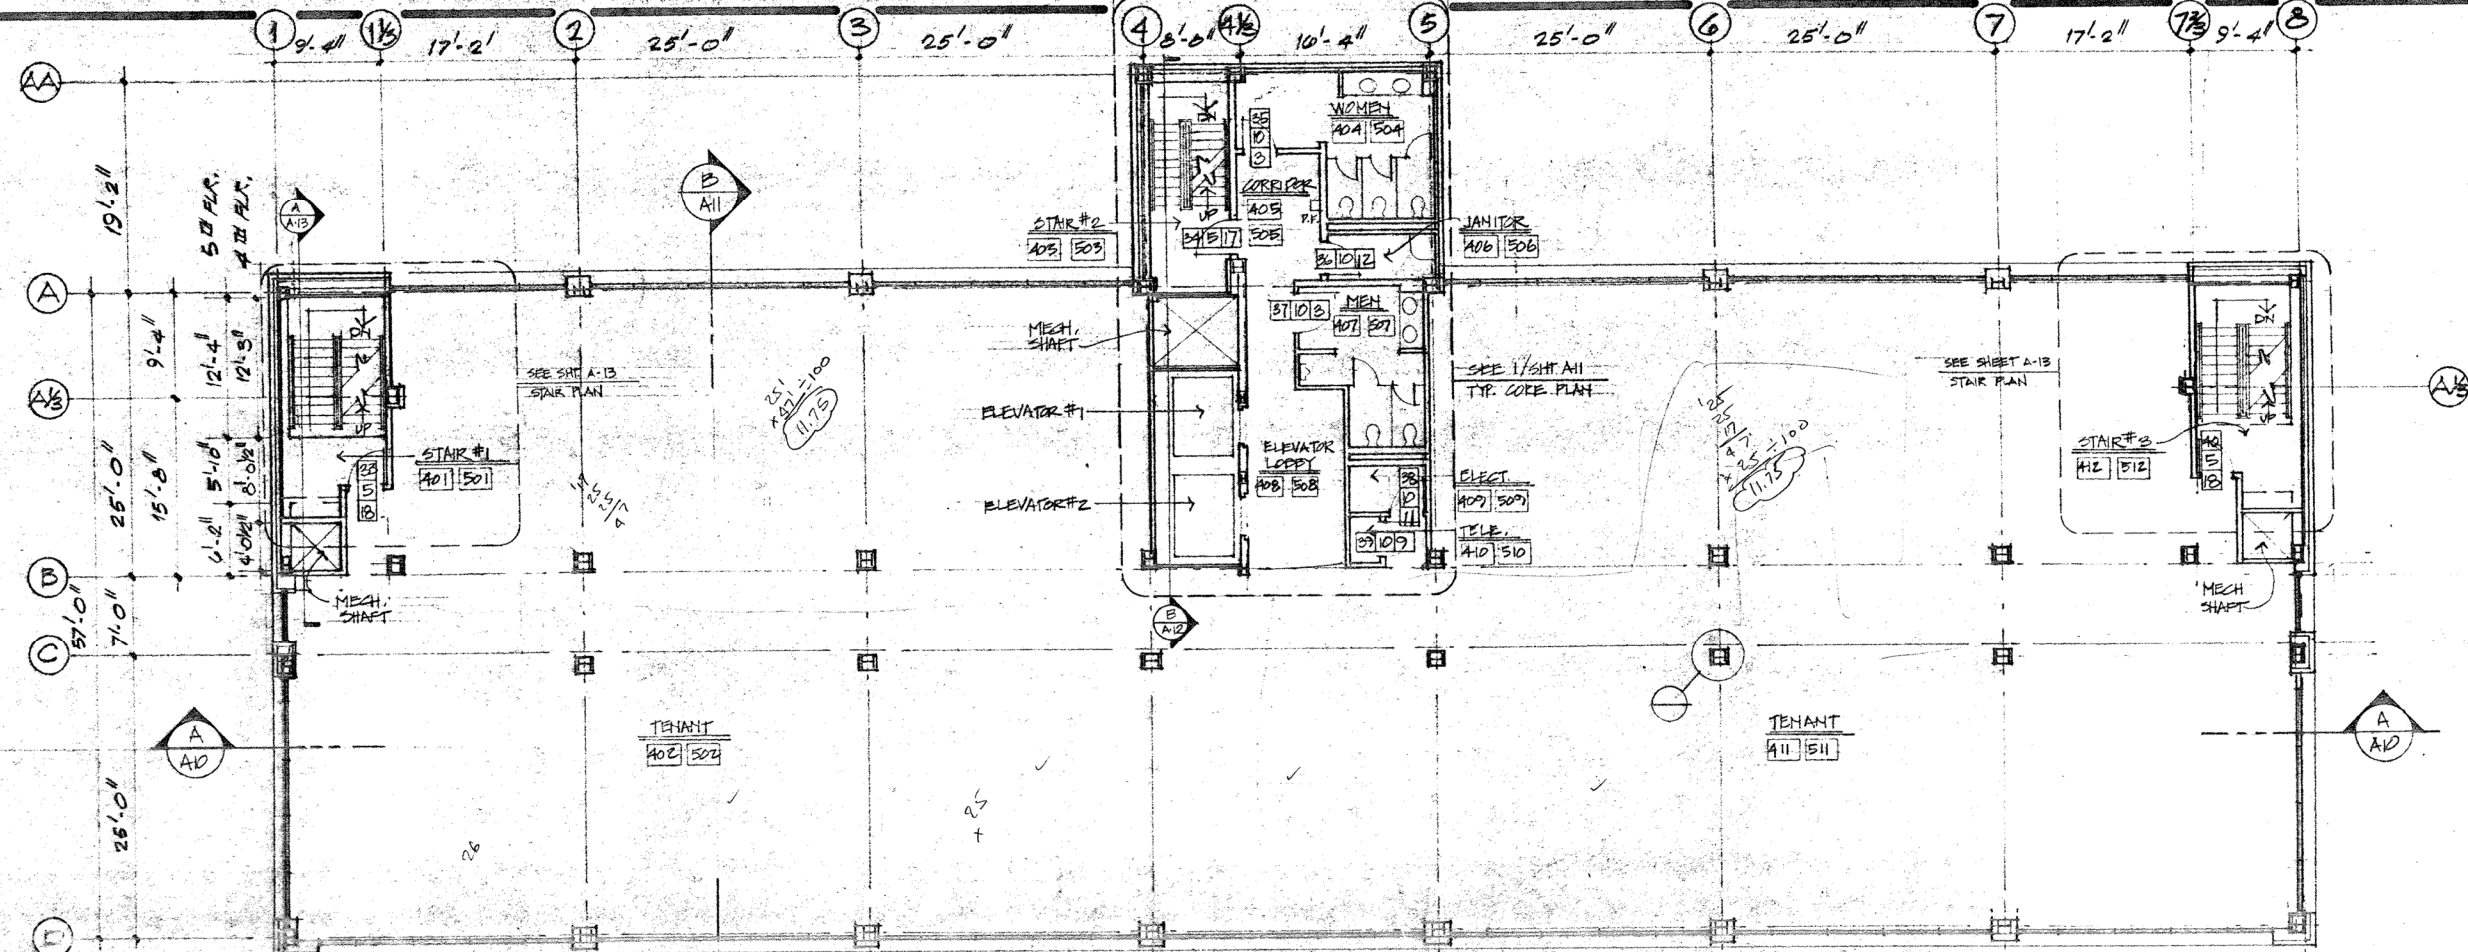

4TH & 5TH FLR. PLAN
SCALE: 1/8" = 1'-0"

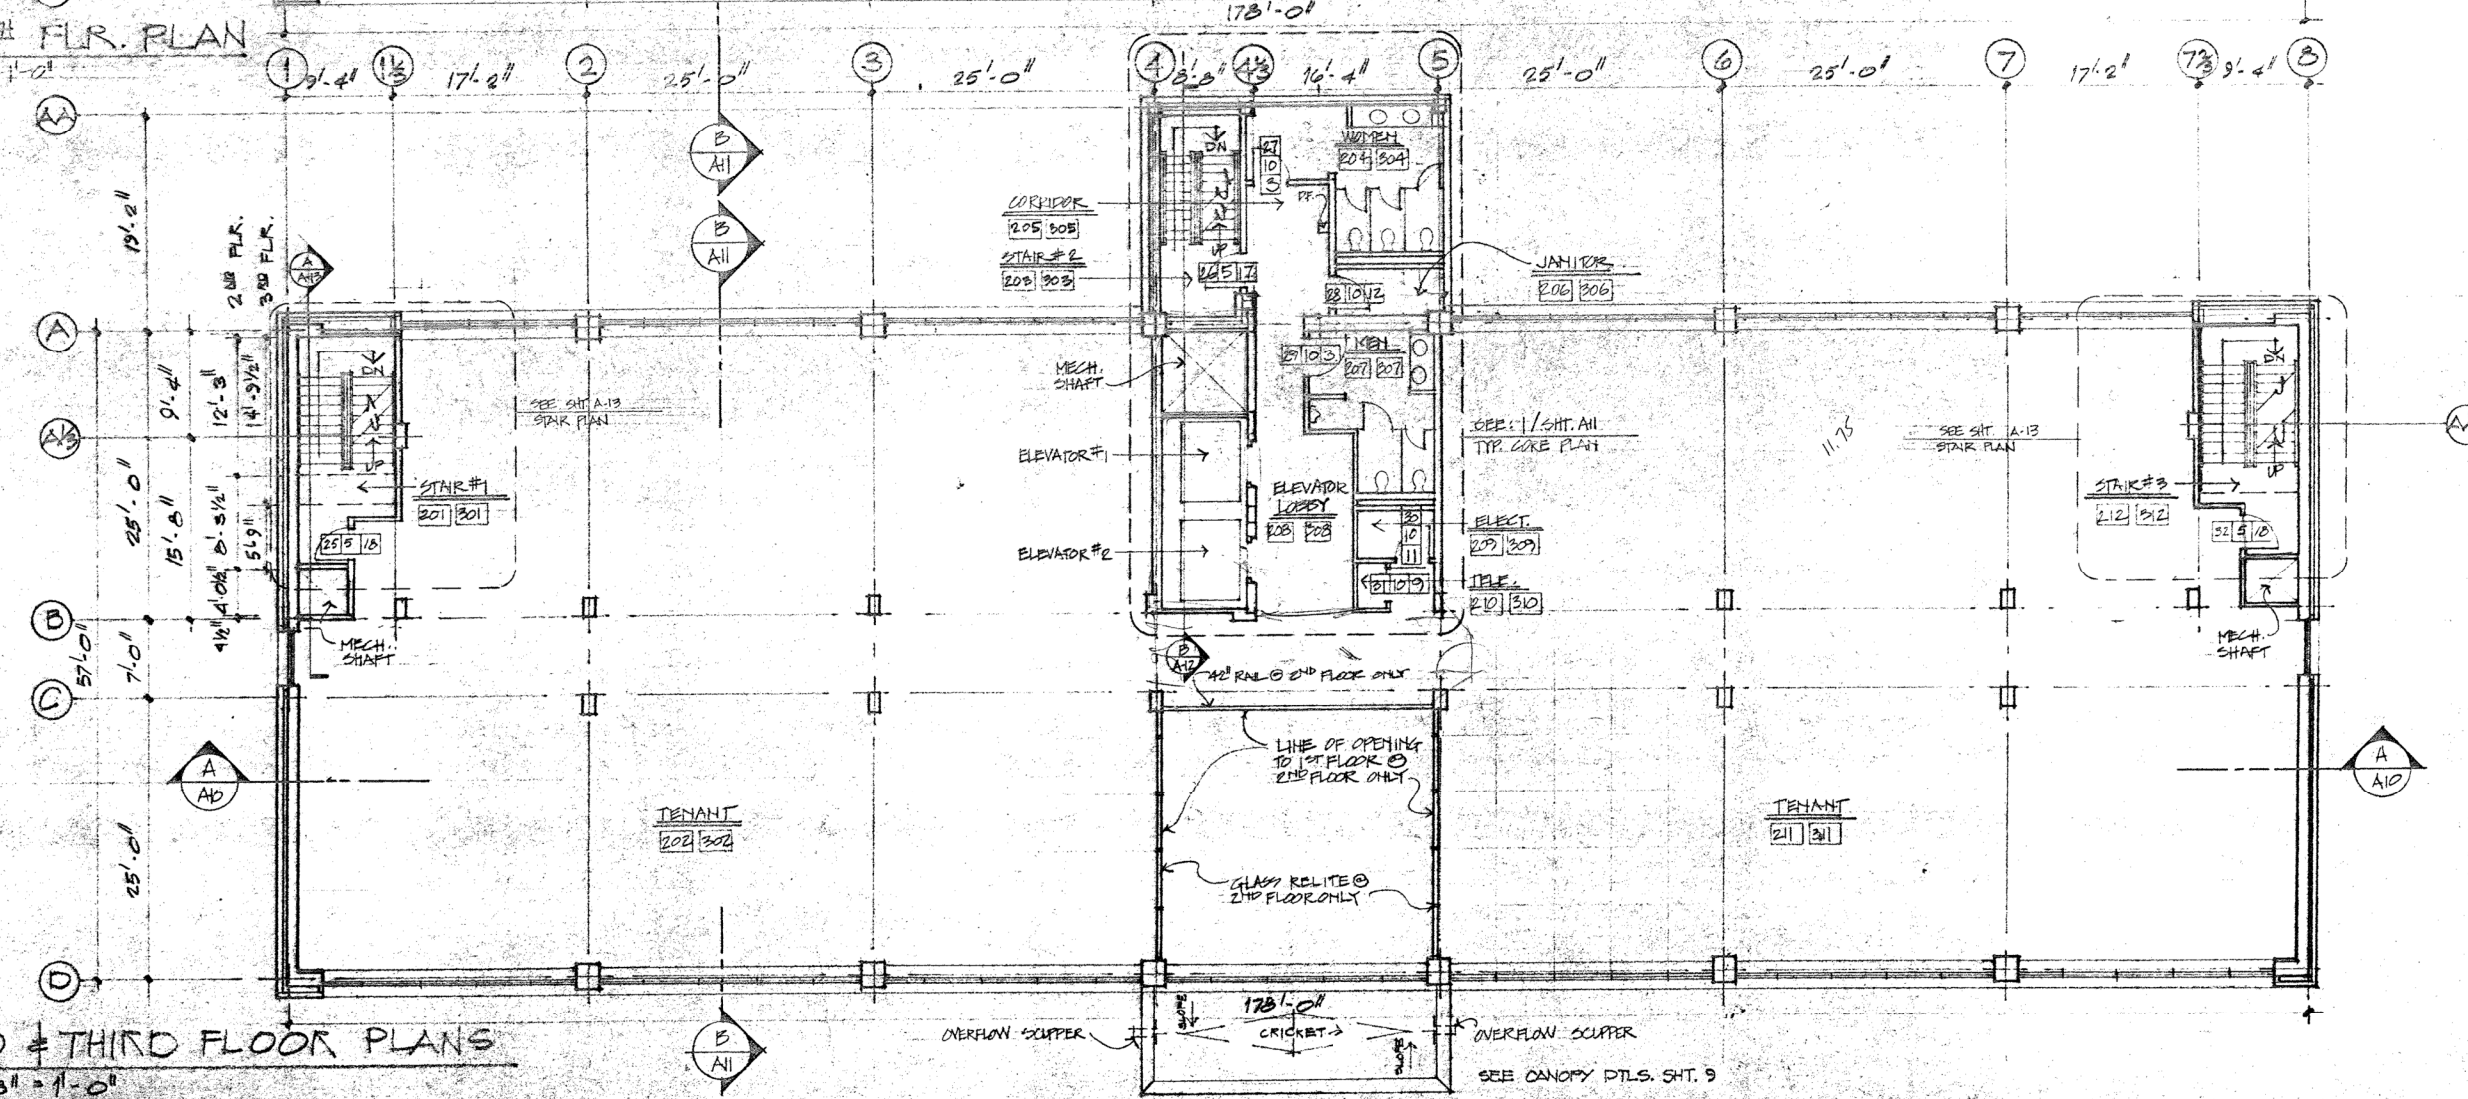


SECOND & THIRD FLOOR PLANS
SCALE: 1/8" = 1'-0"




**NORTHWEST
DESIGN
GROUP**

DATE	7/1/85	DRAWN	R.E.	CHECKED	W.T.
PROJECT NERCO MINERAL BUILDING 1ST & HALL FAIRBANKS, ALASKA					
SHEET A3					
OF					


SEE 4TH & 5TH FLOOR PLANS

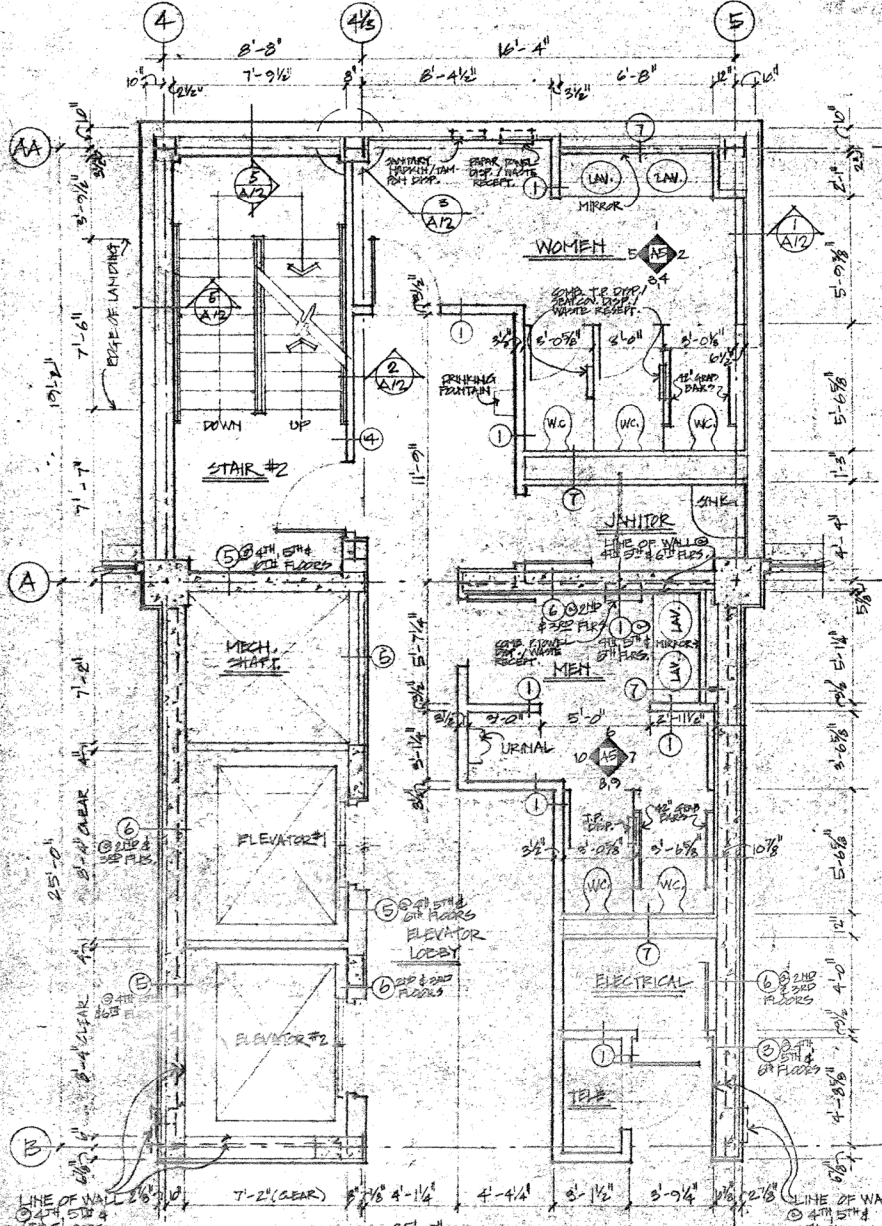


1. 1ST FLOOR CORE PLAN (2ND THRU 6TH FLOORS)
 1/2" = 1'-0"
 NOTE: ALL DIMENSIONS TO FACE OF STUD UNLESS OTHERWISE NOTED
 2. INDICATES WALL TYPE: SEE WALL SCHEDULE ON SHEET A10

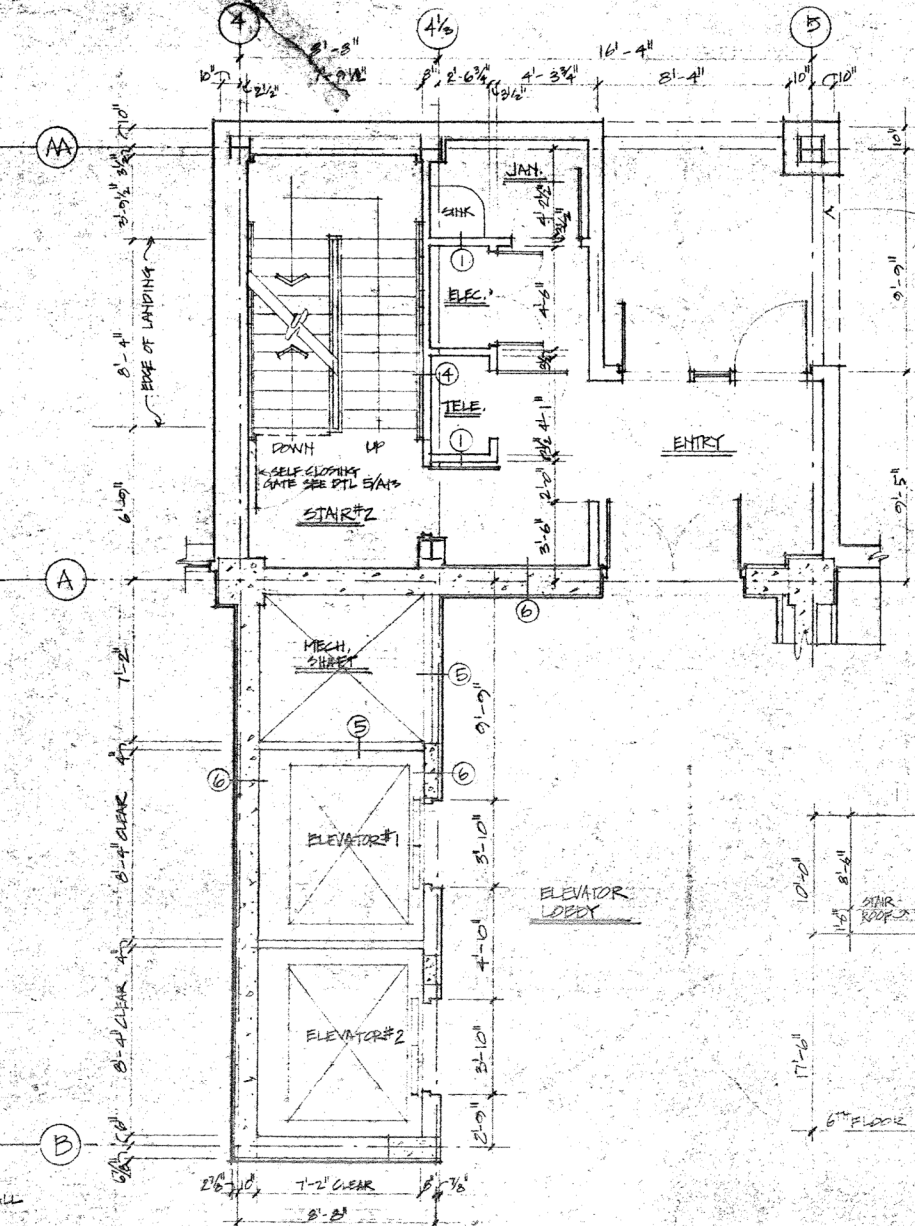


2. 1ST FLOOR CORE PLAN
 1/2" = 1'-0"
 NOTE: ALL DIMENSIONS TO FACE OF STUD UNLESS OTHERWISE NOTED

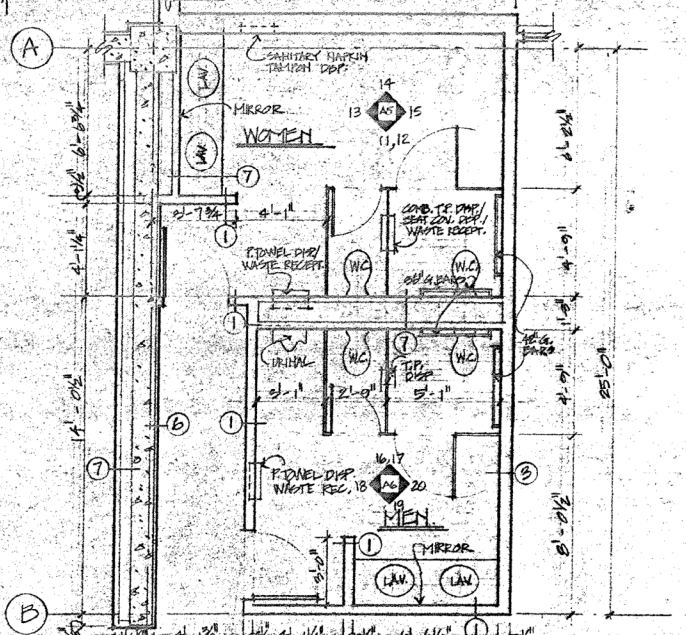

3. 1ST FLOOR RESTROOMS ENLARGED PLAN
 1/4" = 1'-0"



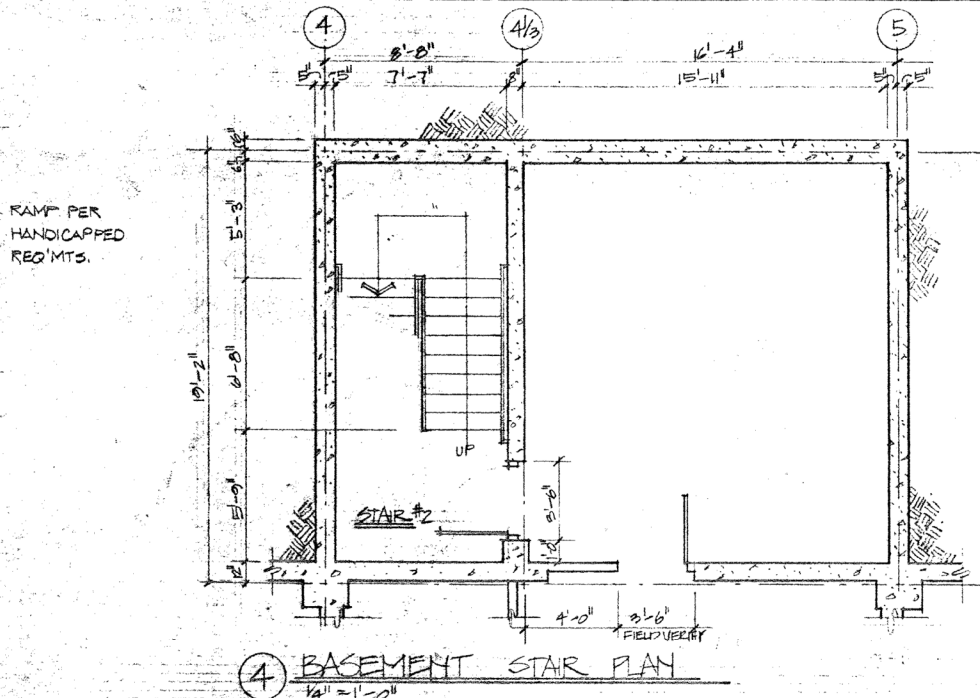



4. BASEMENT STAIR PLAN
 1/4" = 1'-0"

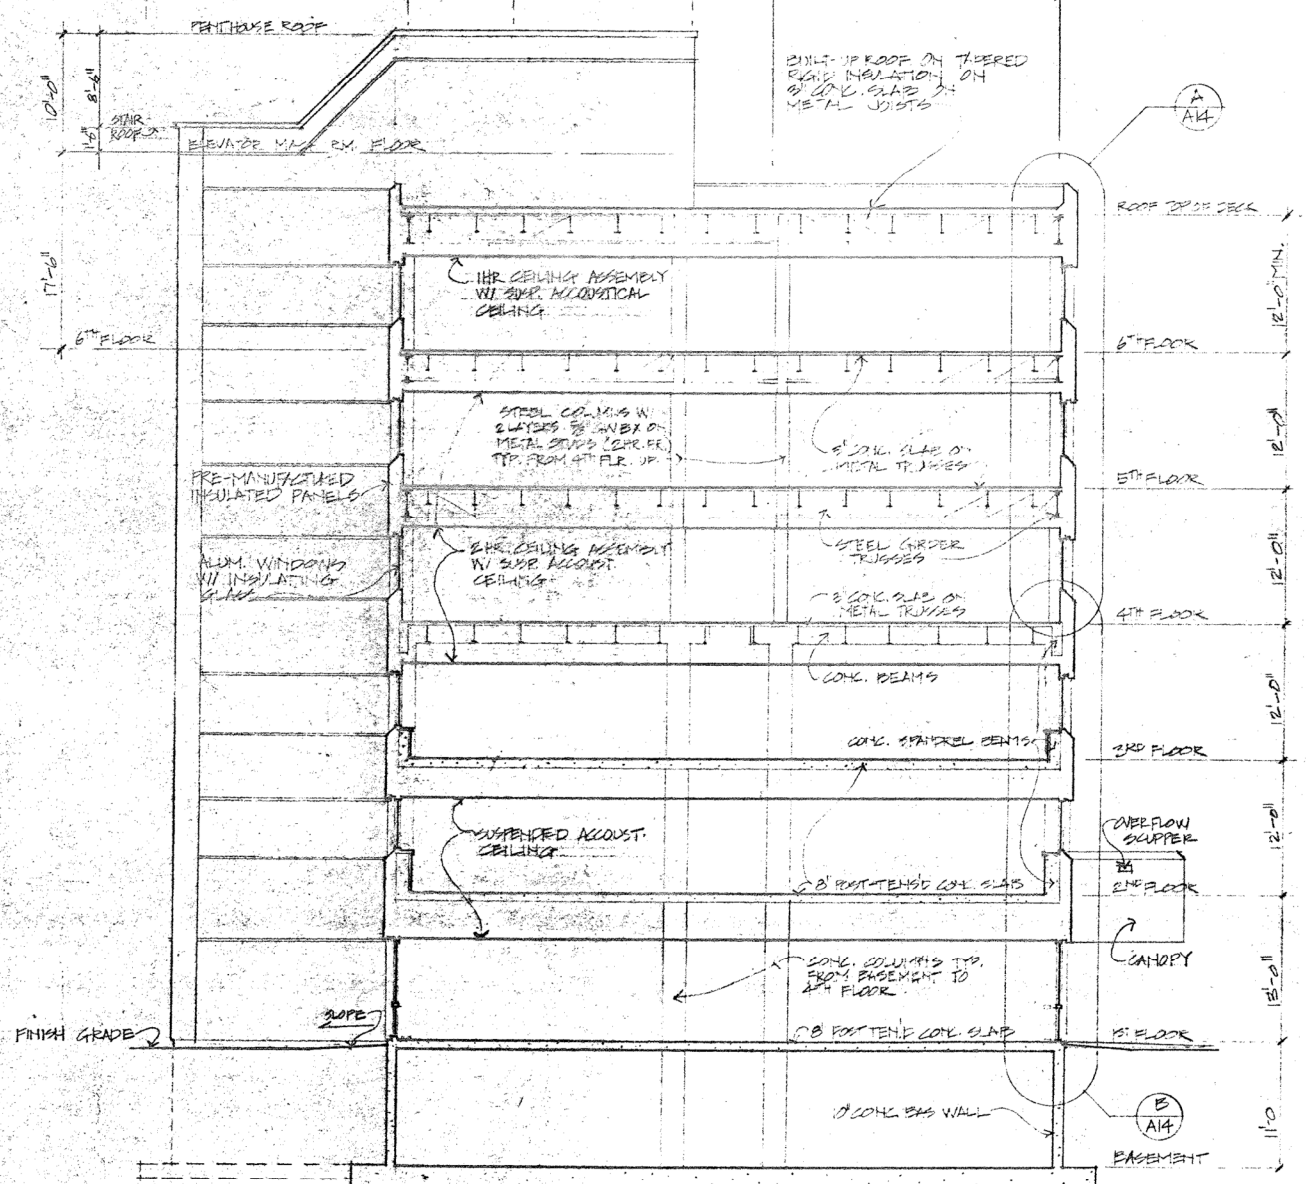


BUILDING SECTION B-B
 1/8" = 1'-0"

NORTHWEST DESIGN GROUP
 DATE: 9/1/85
 DRAWN BY: [Signature]
 CHECKED BY: [Signature]
NERCO MINERAL BUILDING
1ST & HALL FAIRBANKS, ALASKA
 PROJECT: 8501 B
 SHEET: A11
 OF: 1

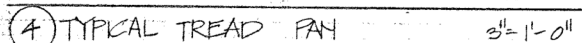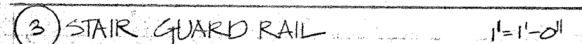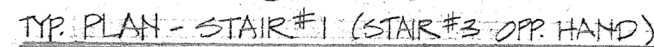


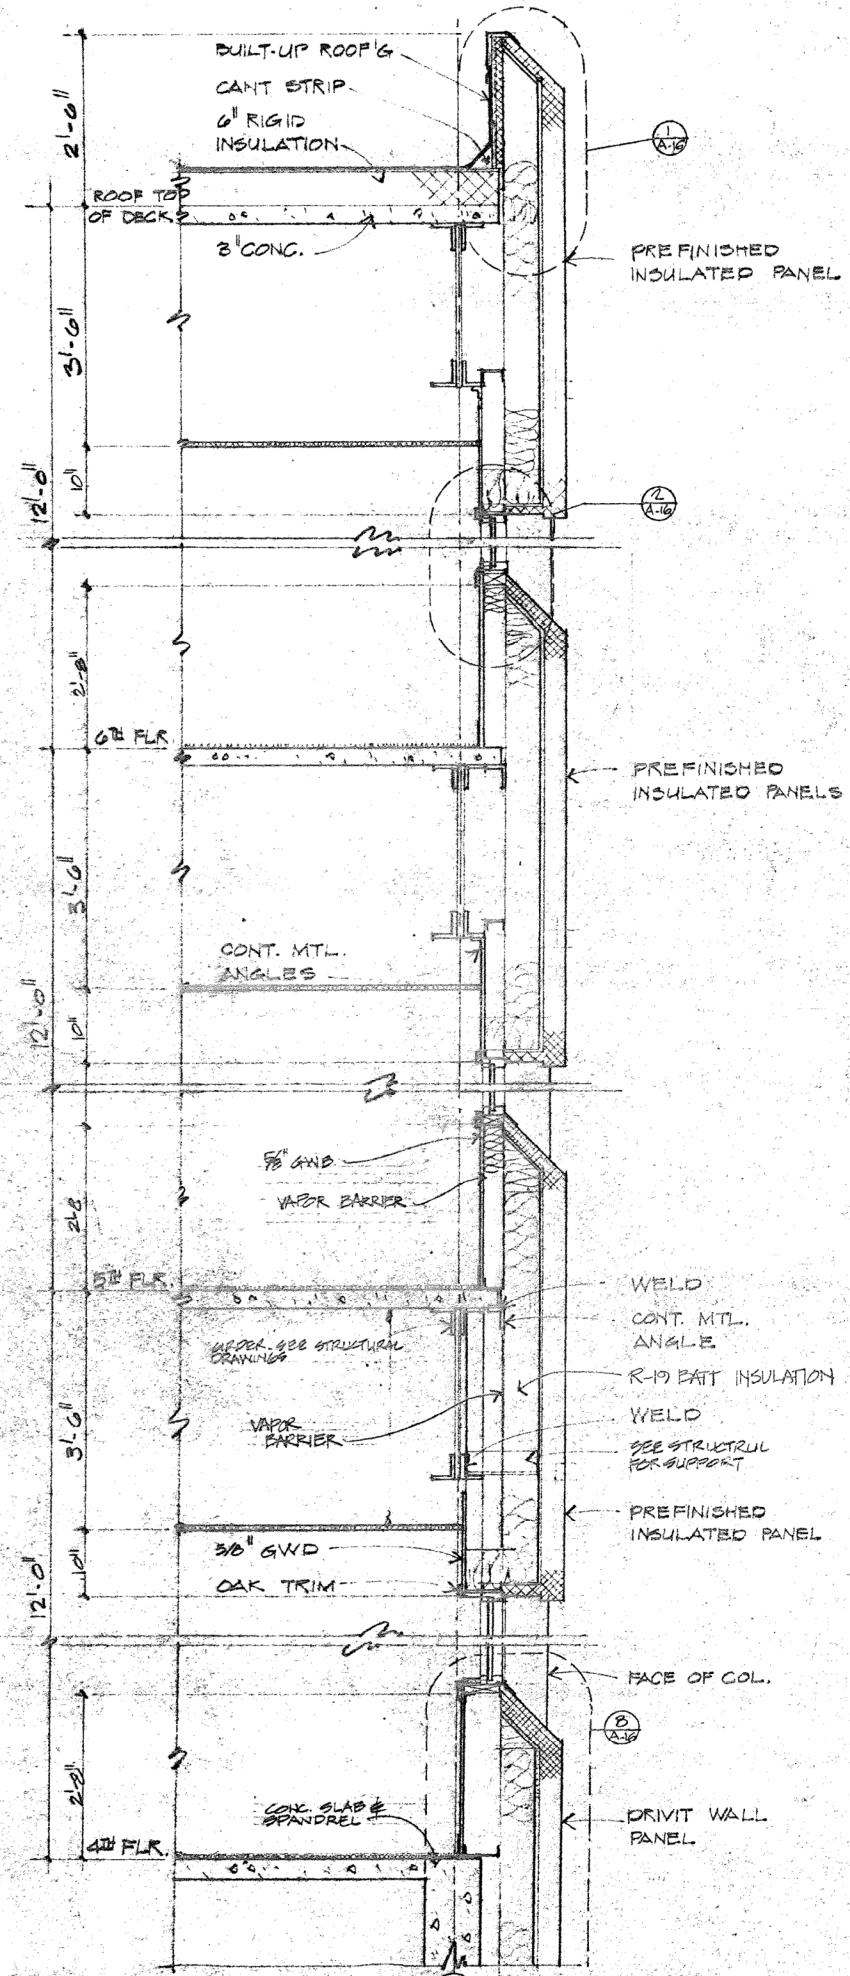

(A) WALL SECTION

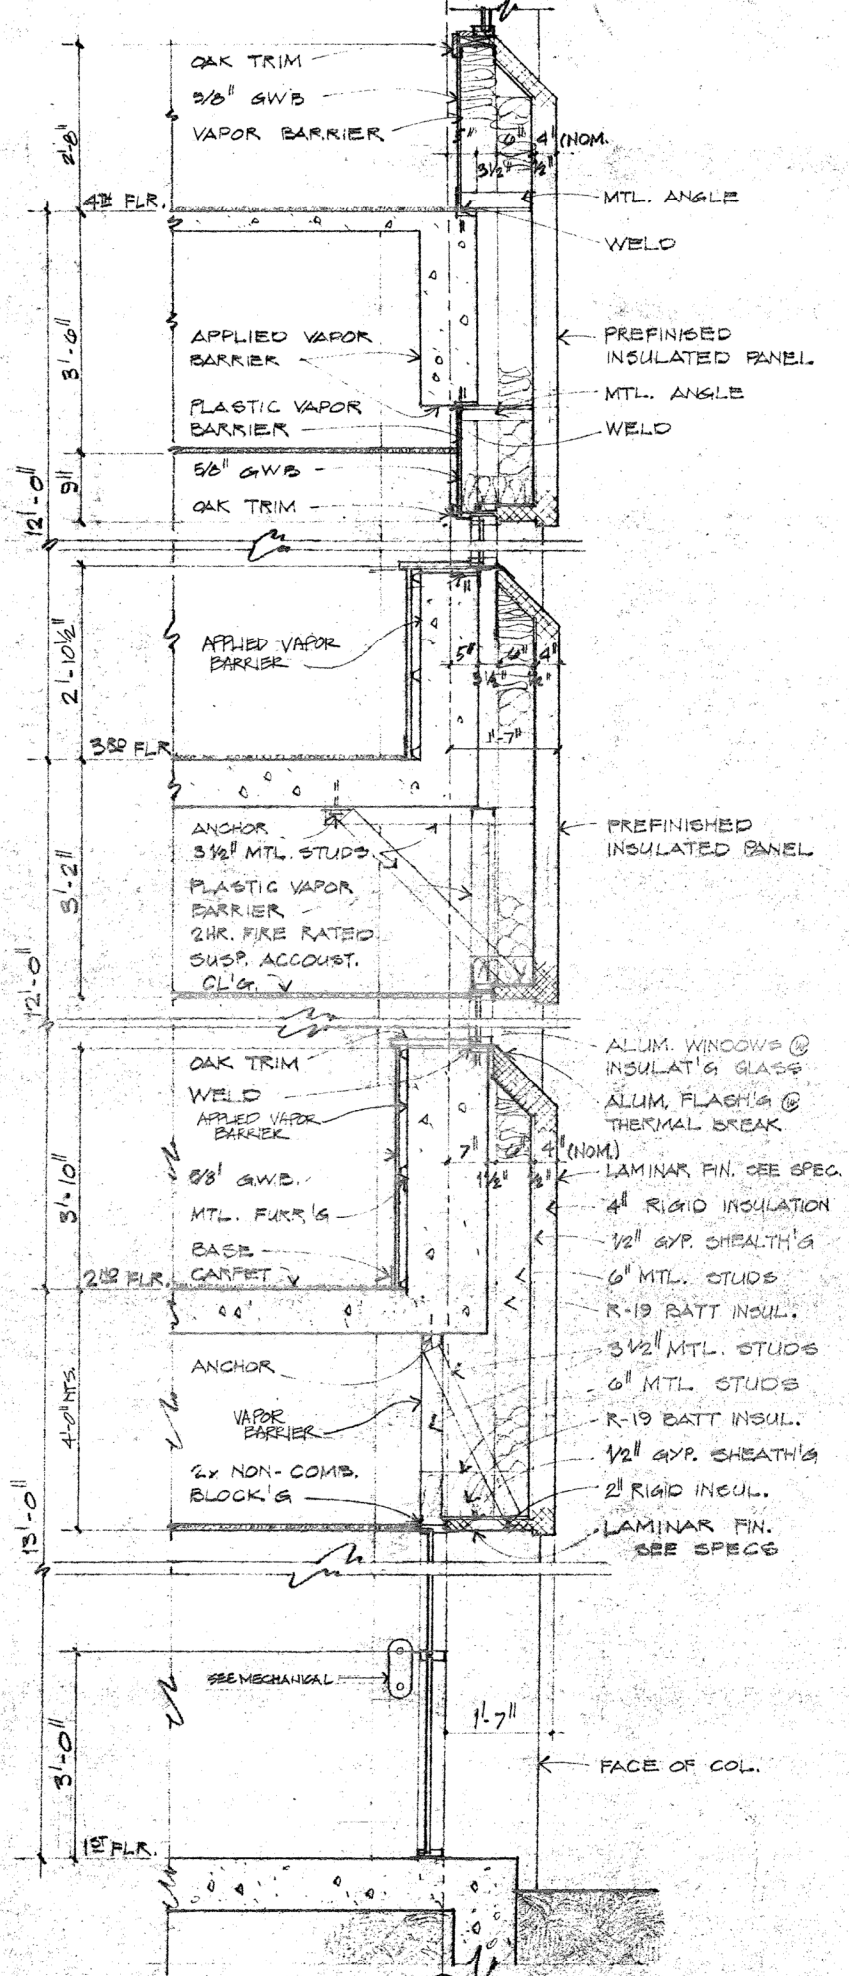

(B) WALL SECTION

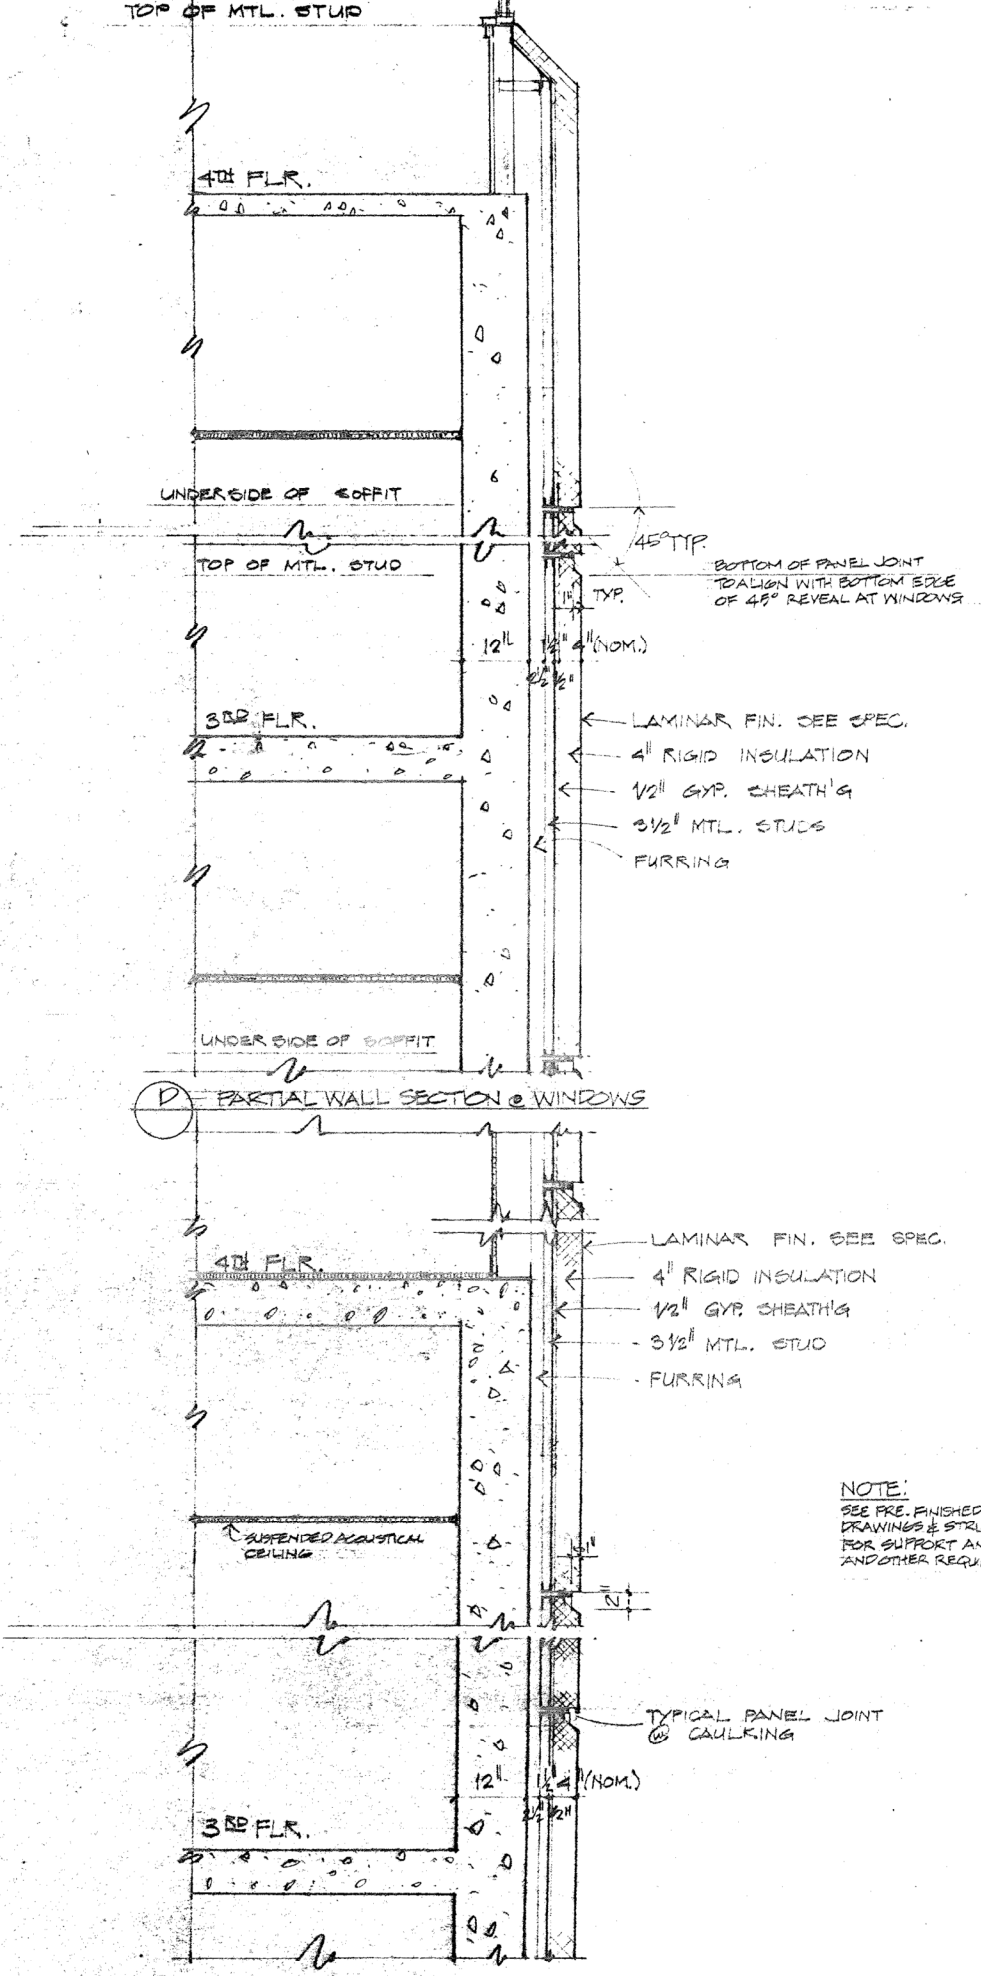

(C) WALL SECTION

NOTE:
SEE PRE-FINISHED PANEL SHOP
DRAWINGS & STRUCTURAL DRAWINGS
FOR SUPPORT ANGLES, STUDS, CORNERS
AND OTHER REQUIRED ANCHORAGE.

**NORTHWEST
DESIGN
GROUP**

DATE	9/1/58	DRAWN	R.F.	CHECKED	V.T.
NERCO MINERAL BUILDING 1ST & HALL FAIRBANKS, ALASKA					
WALL SECTIONS					
PROJECT					
SHEET					
A14					

PROJECT
35212

SHEET
A15

