




JUNE 25, 2024 UPPER TANANA HEALTH CENTER

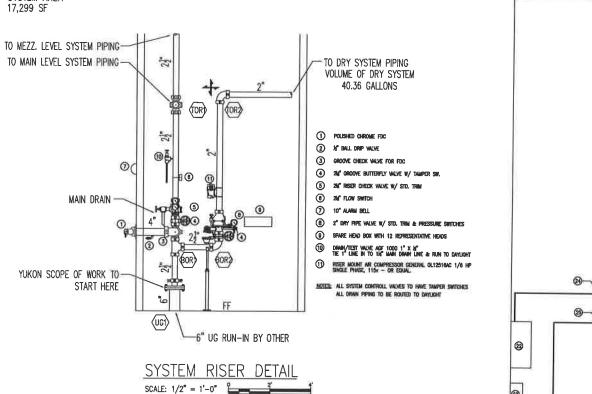

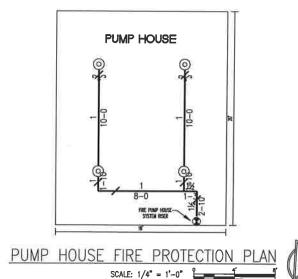

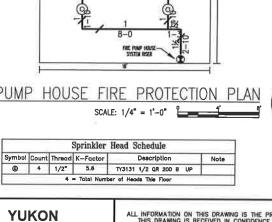


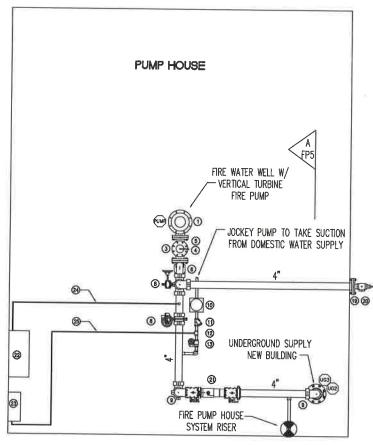


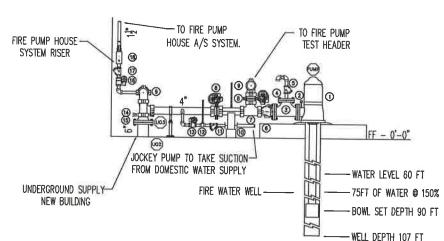


FIRE PUMP PLAN VIEW

SCALE: 1/2" = 1'-0"

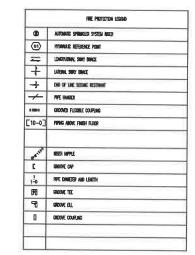

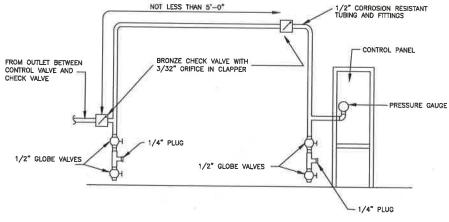

FIRE/JOCKEY PUMP SENSING LINE DETAIL SCALE: N.T.S.

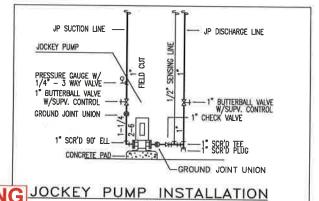

SCALE: 1/2" = 1'-0"

FIRE PUMP SECTION VIEW "A" RECORD DRAWING JOCKEY PUMP INSTALLATION

1/15/20

FIRE PUMP LEGEND

(4) 9" X 1.5" COMPANION FLANG

(B) 4" GROOVE BUTTERFLY VALVE W.

(8) 4° GROOVE CHECK VALVE

AUTOMATIC AR RELEASE VALVE

(0) JOCKEY PUMP - 1.5 HP, 200+ 3 PHASE

1 X 1" X 1/2" TEE FOR SENSING LINE

1 6" X 4" GROOVE CONCENTRIC REDUCE

(8) 1 1/2" THREADED BUTTERSALL VALVE W TAMPER SWITCH

(3) 1" THREADED BUTTERBALL WALVE

1 1/2" THREADED CHECK WALVE

(8) 1 1/2" THREADED RESER WANTFOLD

2 1/2" ANGLE HOSE VALVE

FIRE PUMP CONTROL PANEL

JOCKEY PUMP CONTROL PANEL

FIRE PUMP SENSING LINE

JOCKEY PUMP SENSING LINE

4" DERENGER DOWN (DISS W/ TAMPER

(19) 9" X 2.5" COMPANION FLANCE

(3) 4° FLANGE TEE

7 4" GROOVE TEE

4° CROOVE ELL

1" THRO CHECK WALVE

(15) 6" DROOVE FLANGE

250 GPM @ 140 PSI VERTICAL TURBINE FIRE PUMP 30 HP, 208v 3 PHASE.



SYSTEM AREA

FIRE PROTECTION SERVICES INCORPORATED

5801 SILVERADO WAY ANCHORAGE, ALASKA 99518-1215 (907) 583-3808 FAX: 581-2352

ALL INFORMATION ON THIS DRAWING IS THE PROPERTY OF YUKON FIRE PROTECTION THIS DRAWING IS RECEIVED IN CONFIDENCE THAT ITS CONTENTS MAY NOT BE DISCLOSED WITHOUT THE PRIOR WRITTEN CONSENT OF YUKON FIRE PROTECTION. MAKES NO WARRANTES AS TO THE ACCURACY OR COMPLETENESS OF THE INFORMATION AND DISCLAIMS ANY LIABILITIES REGARDING I USE EXCEPT THOSE IN THE STANDARD TERMS AND CONDITIONS OF THE SALE FOR ANY INCIDENTAL OR CONSEQUENTIAL DAMAGES ARISING FROM THE SALE, RESALE, USE MILLS OF THE PRODUCT.

| | | REVISIONS | | | |
|-----|---------|-------------|-------|---------|---------|
| NO. | DATE | DESCRIPTION | DRAWN | CHECKCO | AFFROND |
| 00 | 1-15-20 | PRELIMINARY | NS | | |
| | | | | | |
| | | | | | |
| | | | | | |
| | | | | | |
| | | | | | _ |

N. STEPHENS SEAN J GUILLORY, CET. LISC. NO. 04-037 SEAN J GUILLORY, CET. LISC. NO. 04-037 LISC. NO.

UPPER TANANA HEALTH CLINIC TOK, ALASKA FIRE PUMP/ RISER DETAIL PLAN

JOB &